


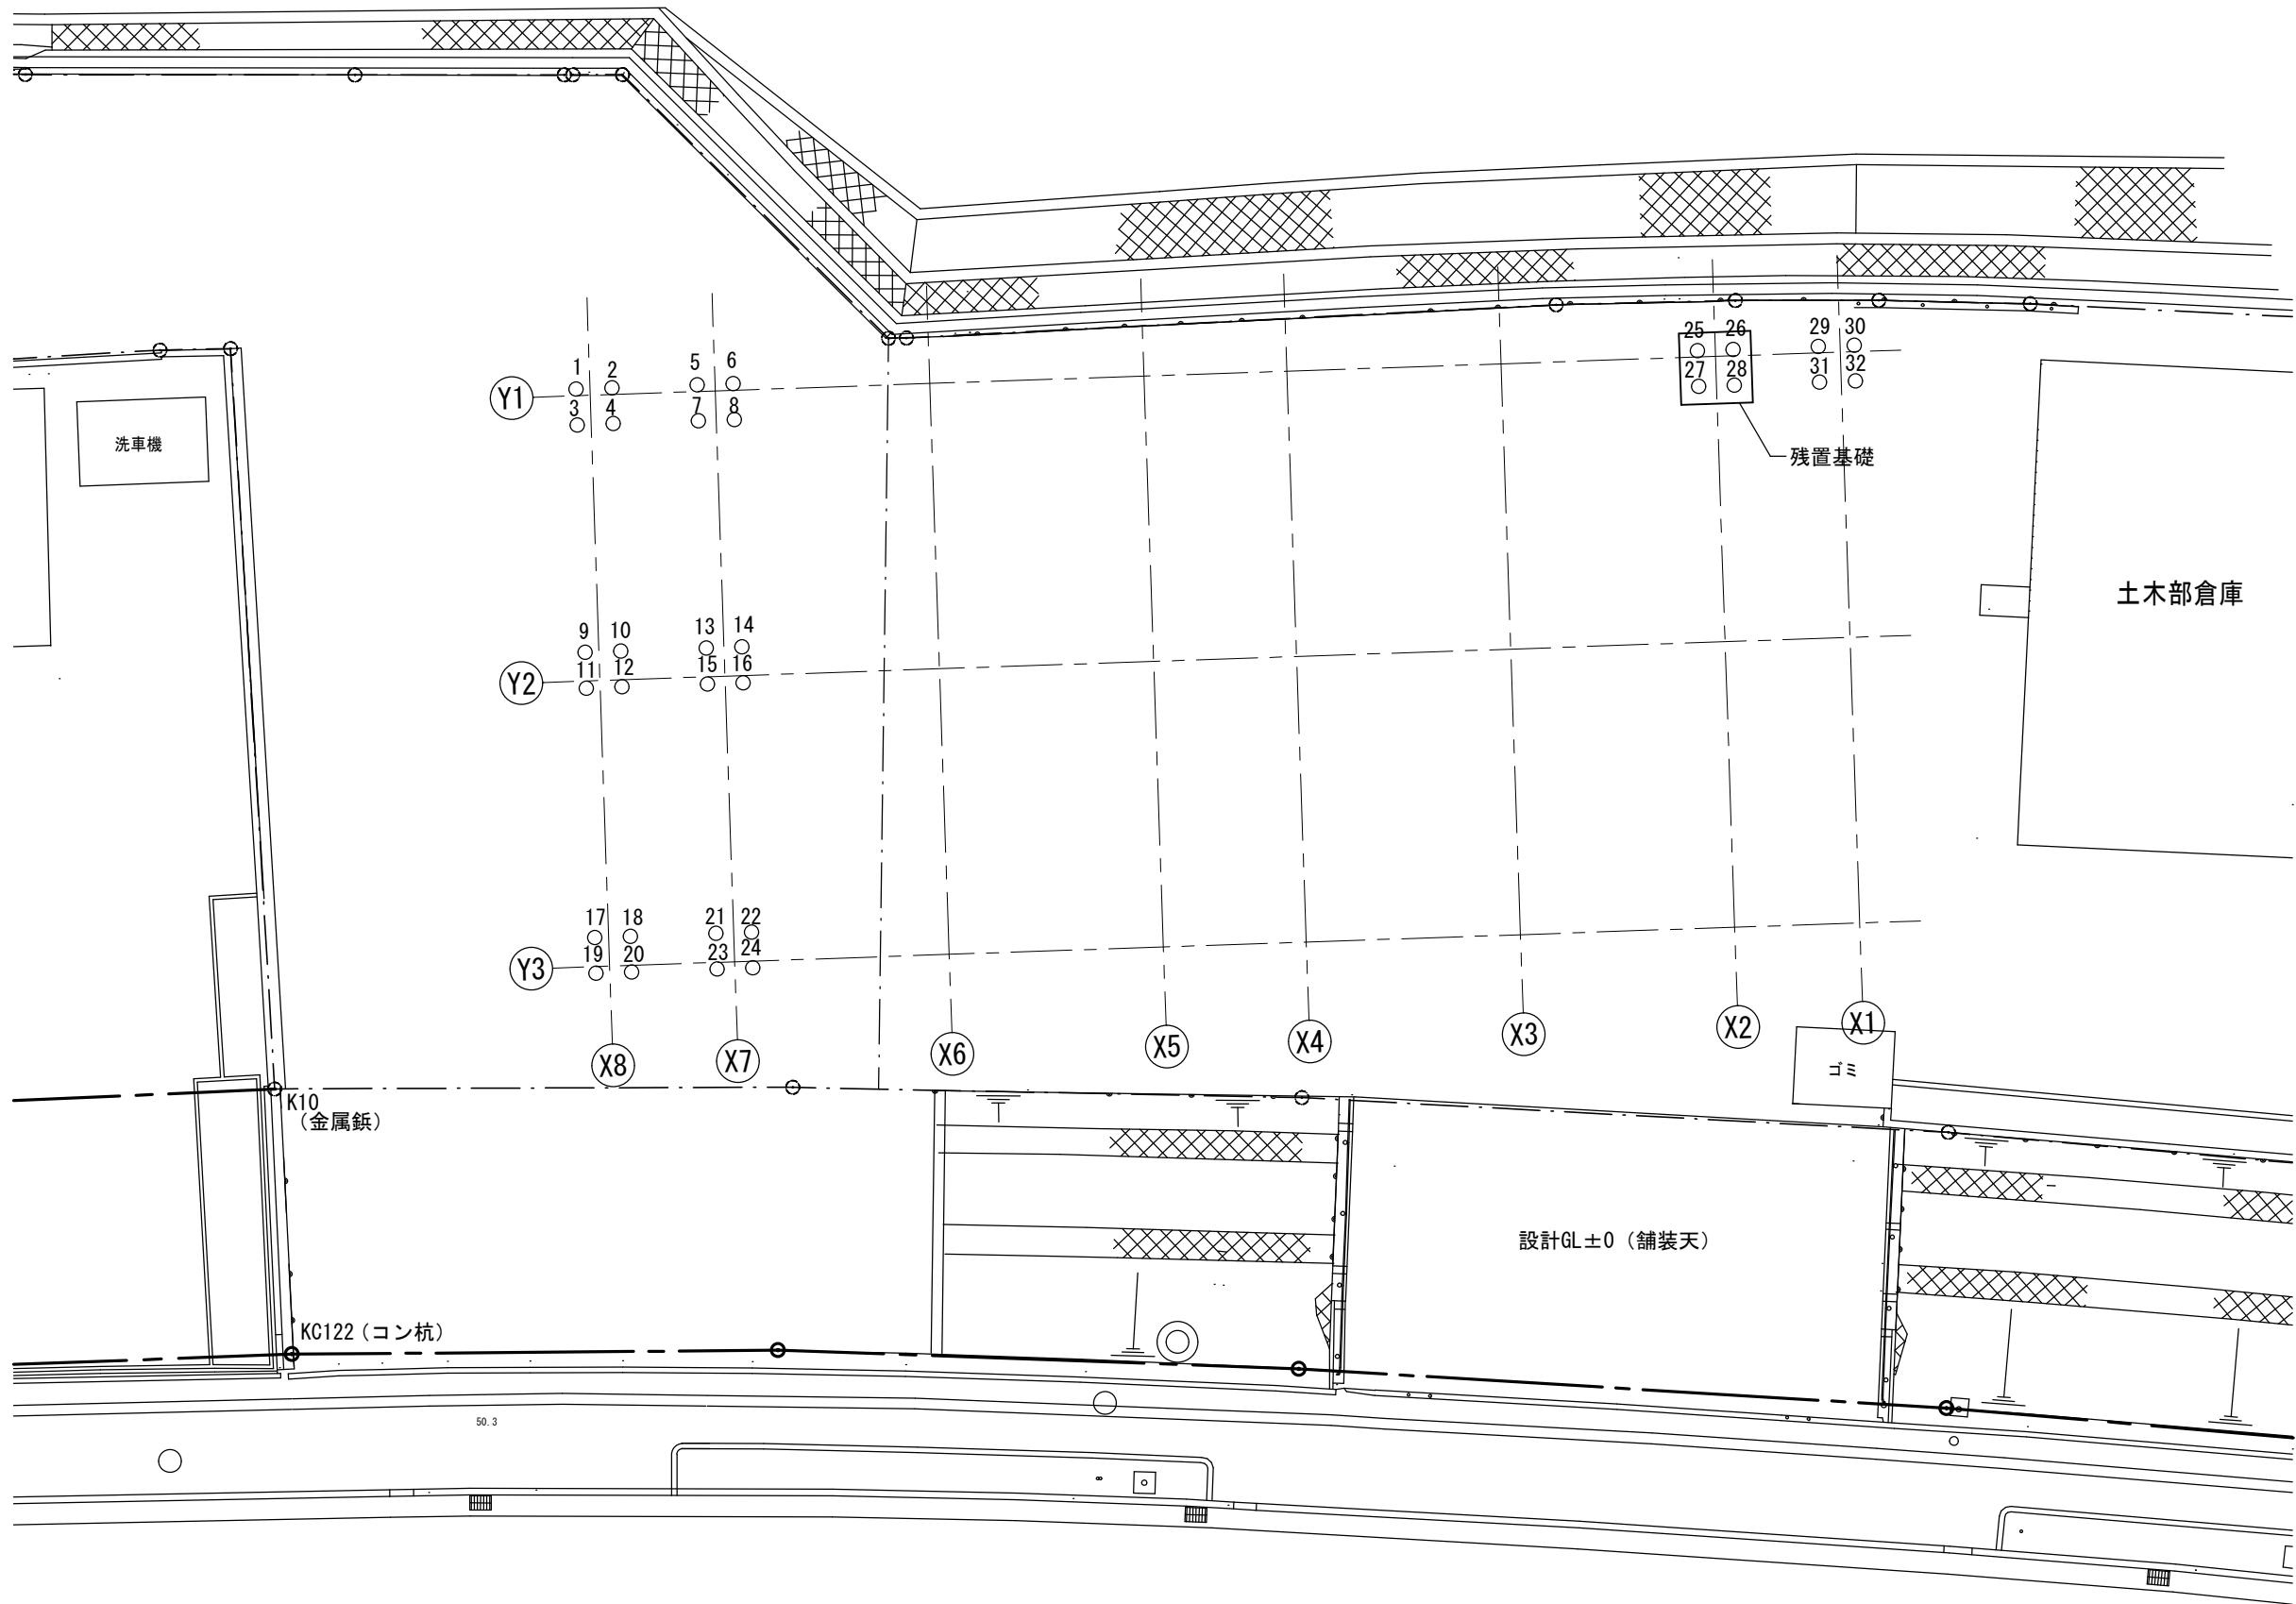

	x	y	設計GLからの杭頭の高さ
KC122	-133946.051	-45013.156	
K10	-133945.444	-45005.650	
1	-133953.340	-44986.360	-2200
2	-133954.455	-44986.079	-2200
3	-133953.213	-44985.495	-2200
4	-133954.304	-44985.158	-2200
5	-133956.746	-44985.088	-2200
6	-133955.773	-44984.656	-2200
7	-133956.405	-44986.301	-2200
8	-133957.254	-44986.248	-2200
9	-133954.107	-44995.659	-1650
10	-133954.722	-44992.275	-1650
11	-133953.662	-44992.658	-1650
12	-133954.689	-44993.416	-1650
13	-133950.627	-44994.662	-1650
14	-133958.125	-44993.147	-1650
15	-133958.065	-44994.134	-1650
16	-133957.029	-44992.412	-1650
17	-133954.391	-45000.815	-1650
18	-133955.292	-45000.539	-1650
19	-133954.445	-45001.576	-1650
20	-133955.311	-45001.279	-1650
21	-133957.799	-45000.176	-1650
22	-133958.005	-44999.943	-1650
23	-133957.689	-45001.207	-1650
24	-133958.594	-45001.026	-1650
25	-134014.766	-45009.422	-2200
26	-134015.604	-45009.224	-2200
27	-134014.329	-45010.023	-2200
28	-134015.477	-45010.114	-2200
29	-134018.507	-45011.001	-2200
30	-134019.284	-45010.867	-2200
31	-134018.064	-45011.505	-2200
32	-134019.480	-45011.467	-2200

完成図

工事名	吹田市南千里庁舎事務所棟解体撤去工事		
図面名	残置杭測量図	縮尺	1/100 (A1)
設計	株式会社あい設計		1/200 (A3)
	令和 年 月 日	図面番号	S-015