



吹田市配管図 10

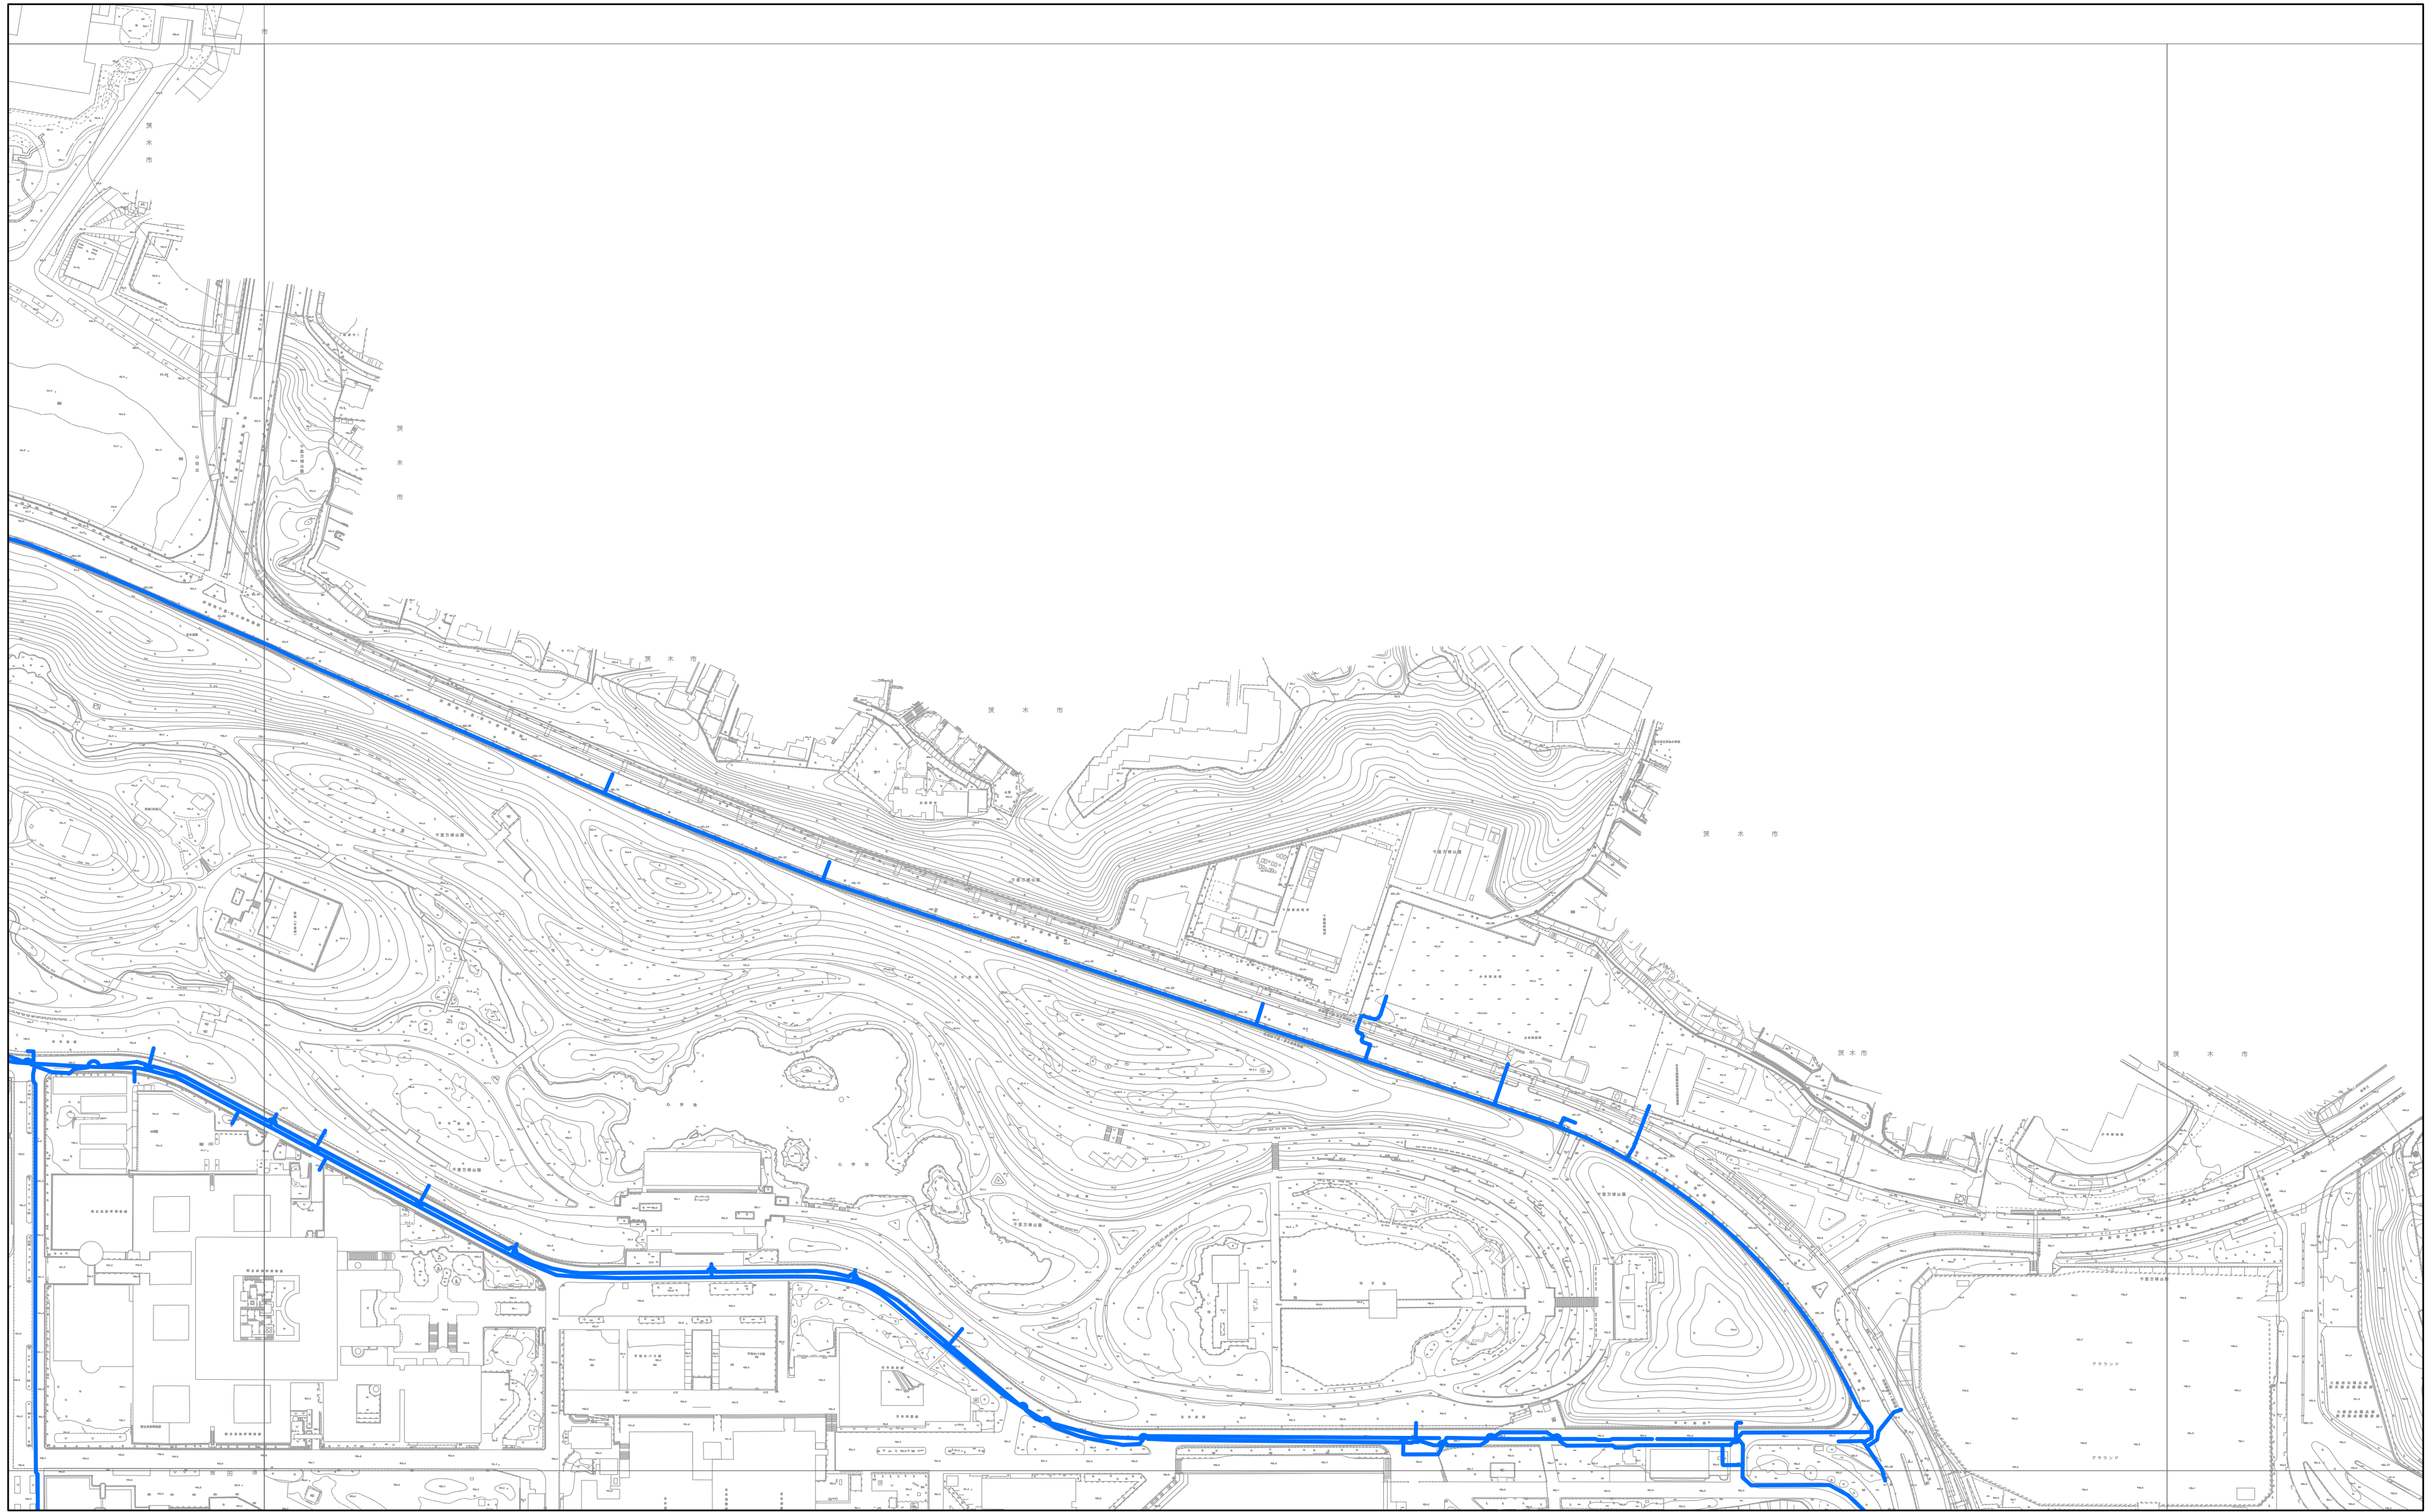

1:2,500

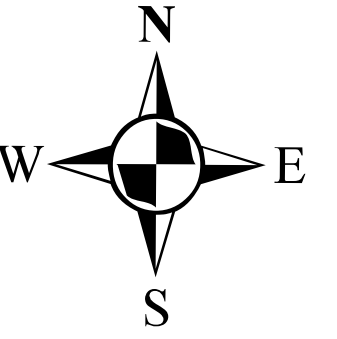