




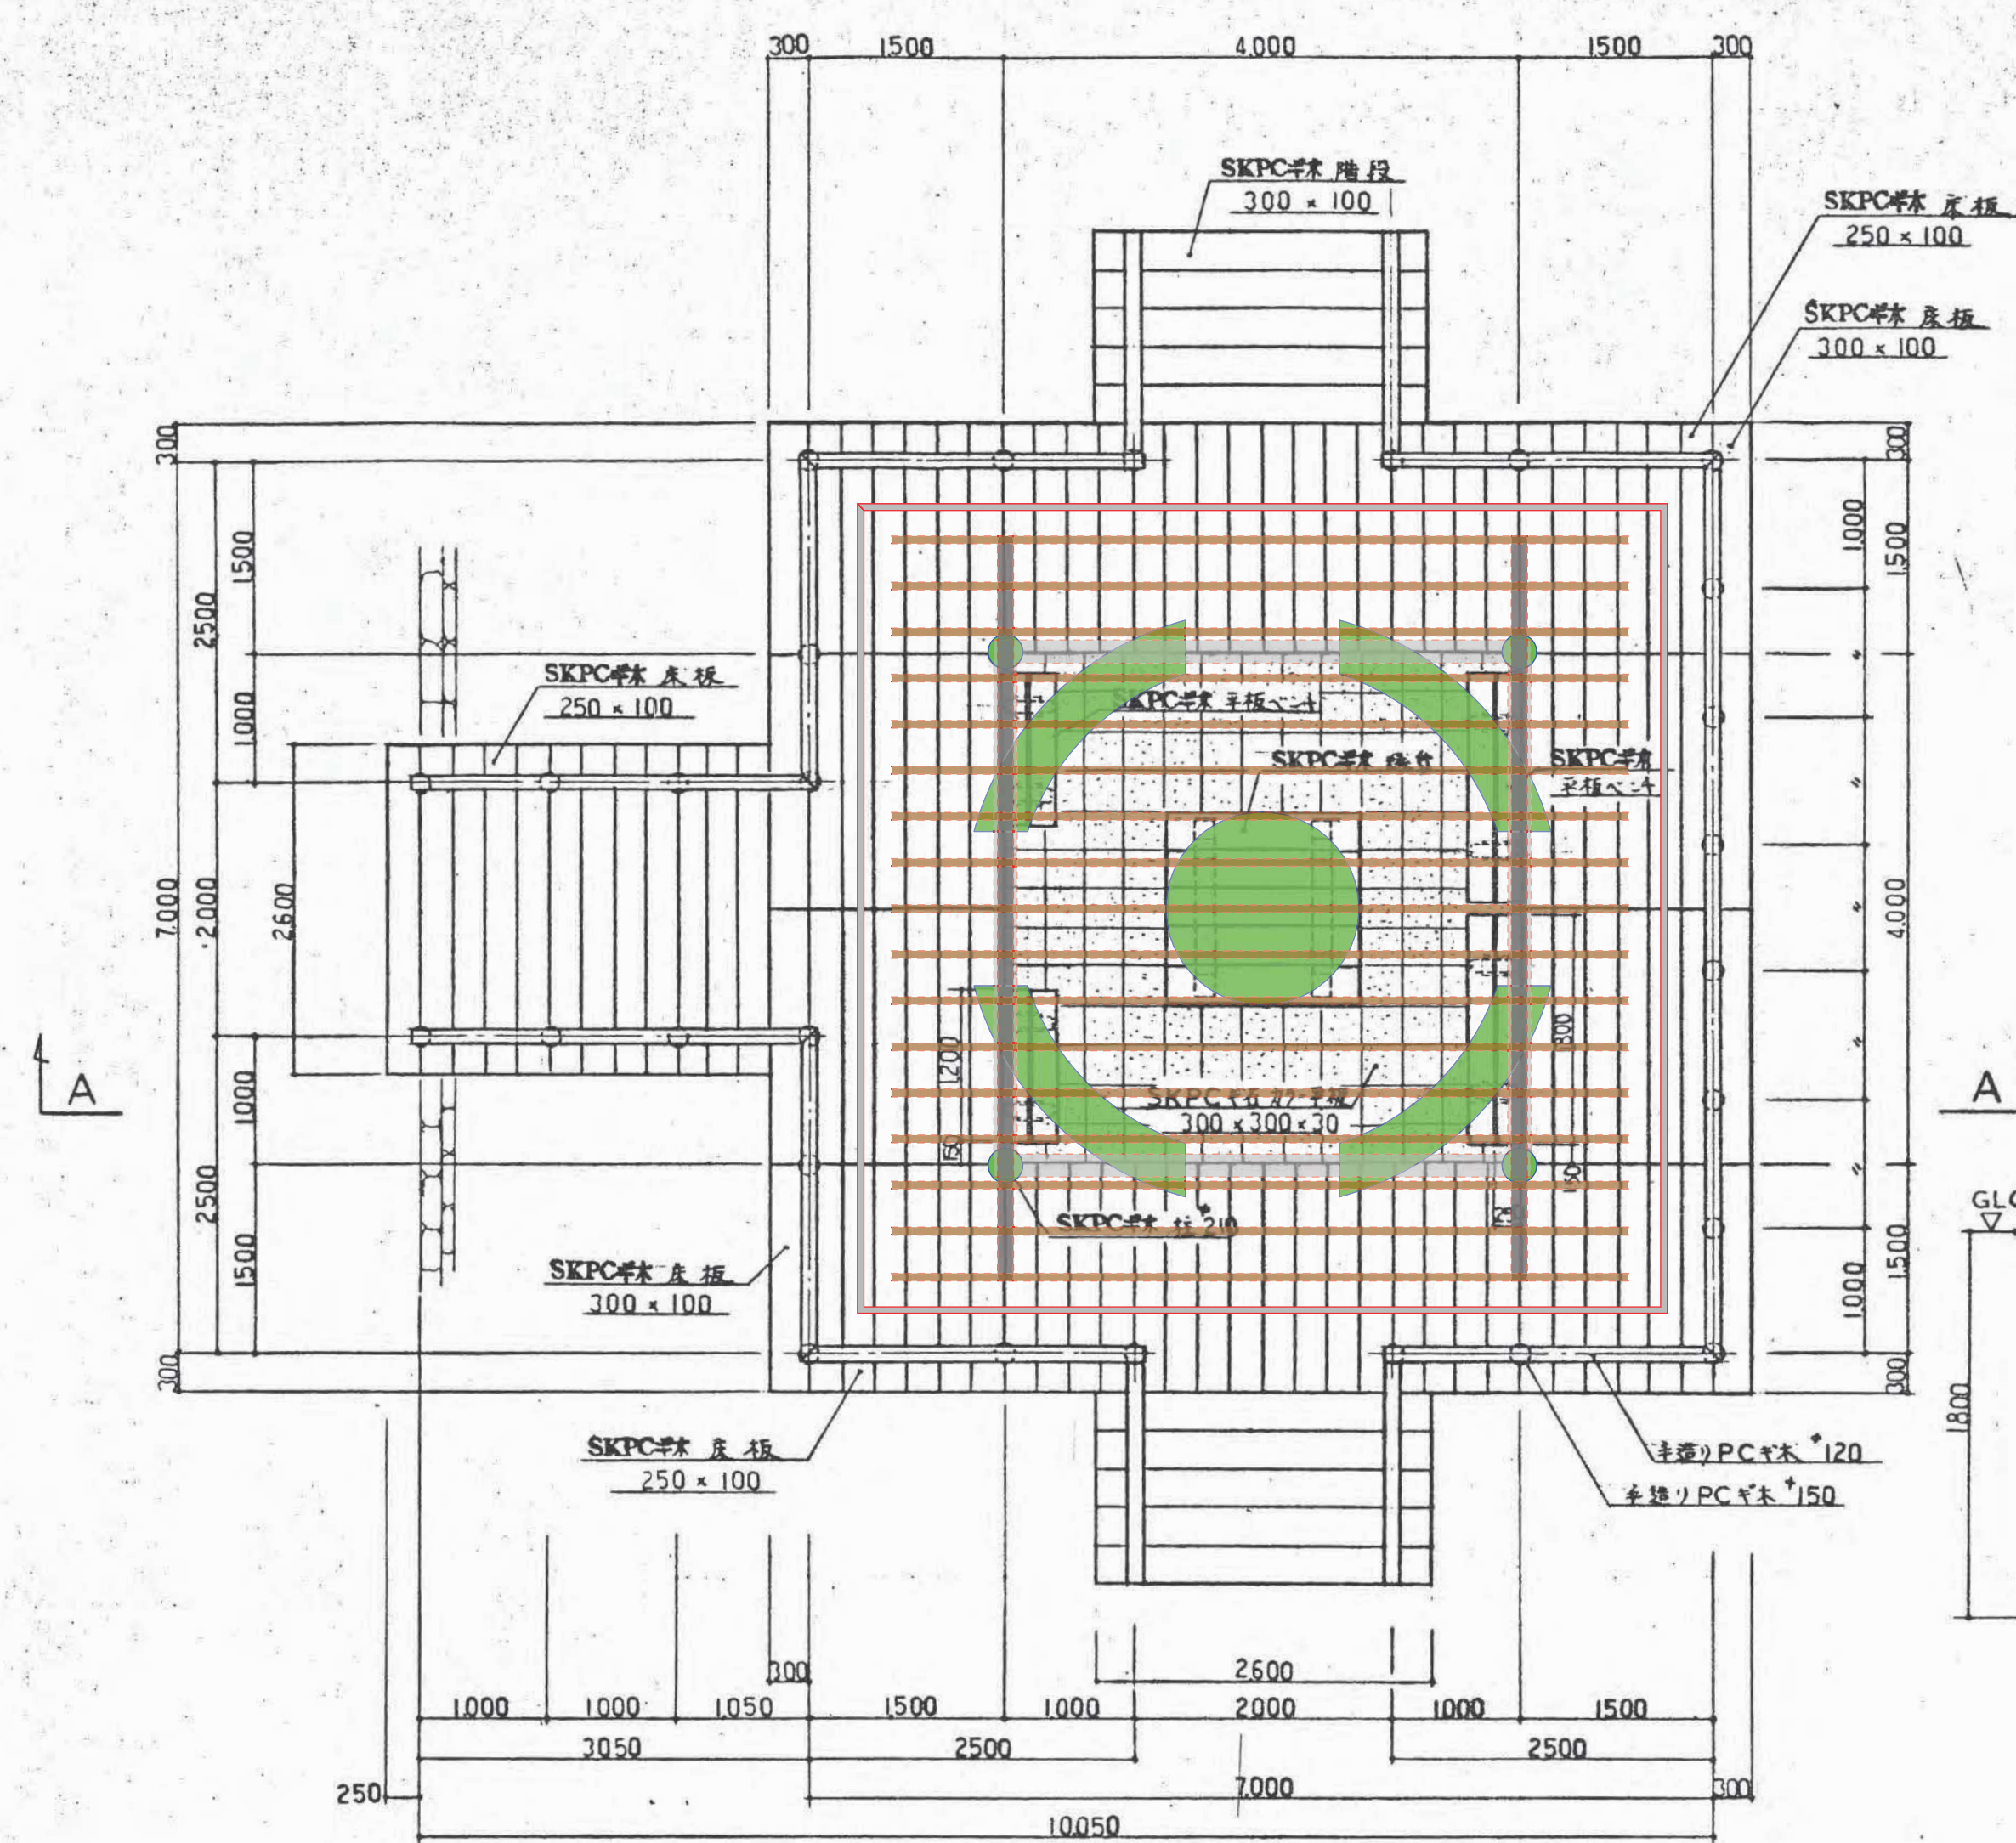


平面図 S=1:50

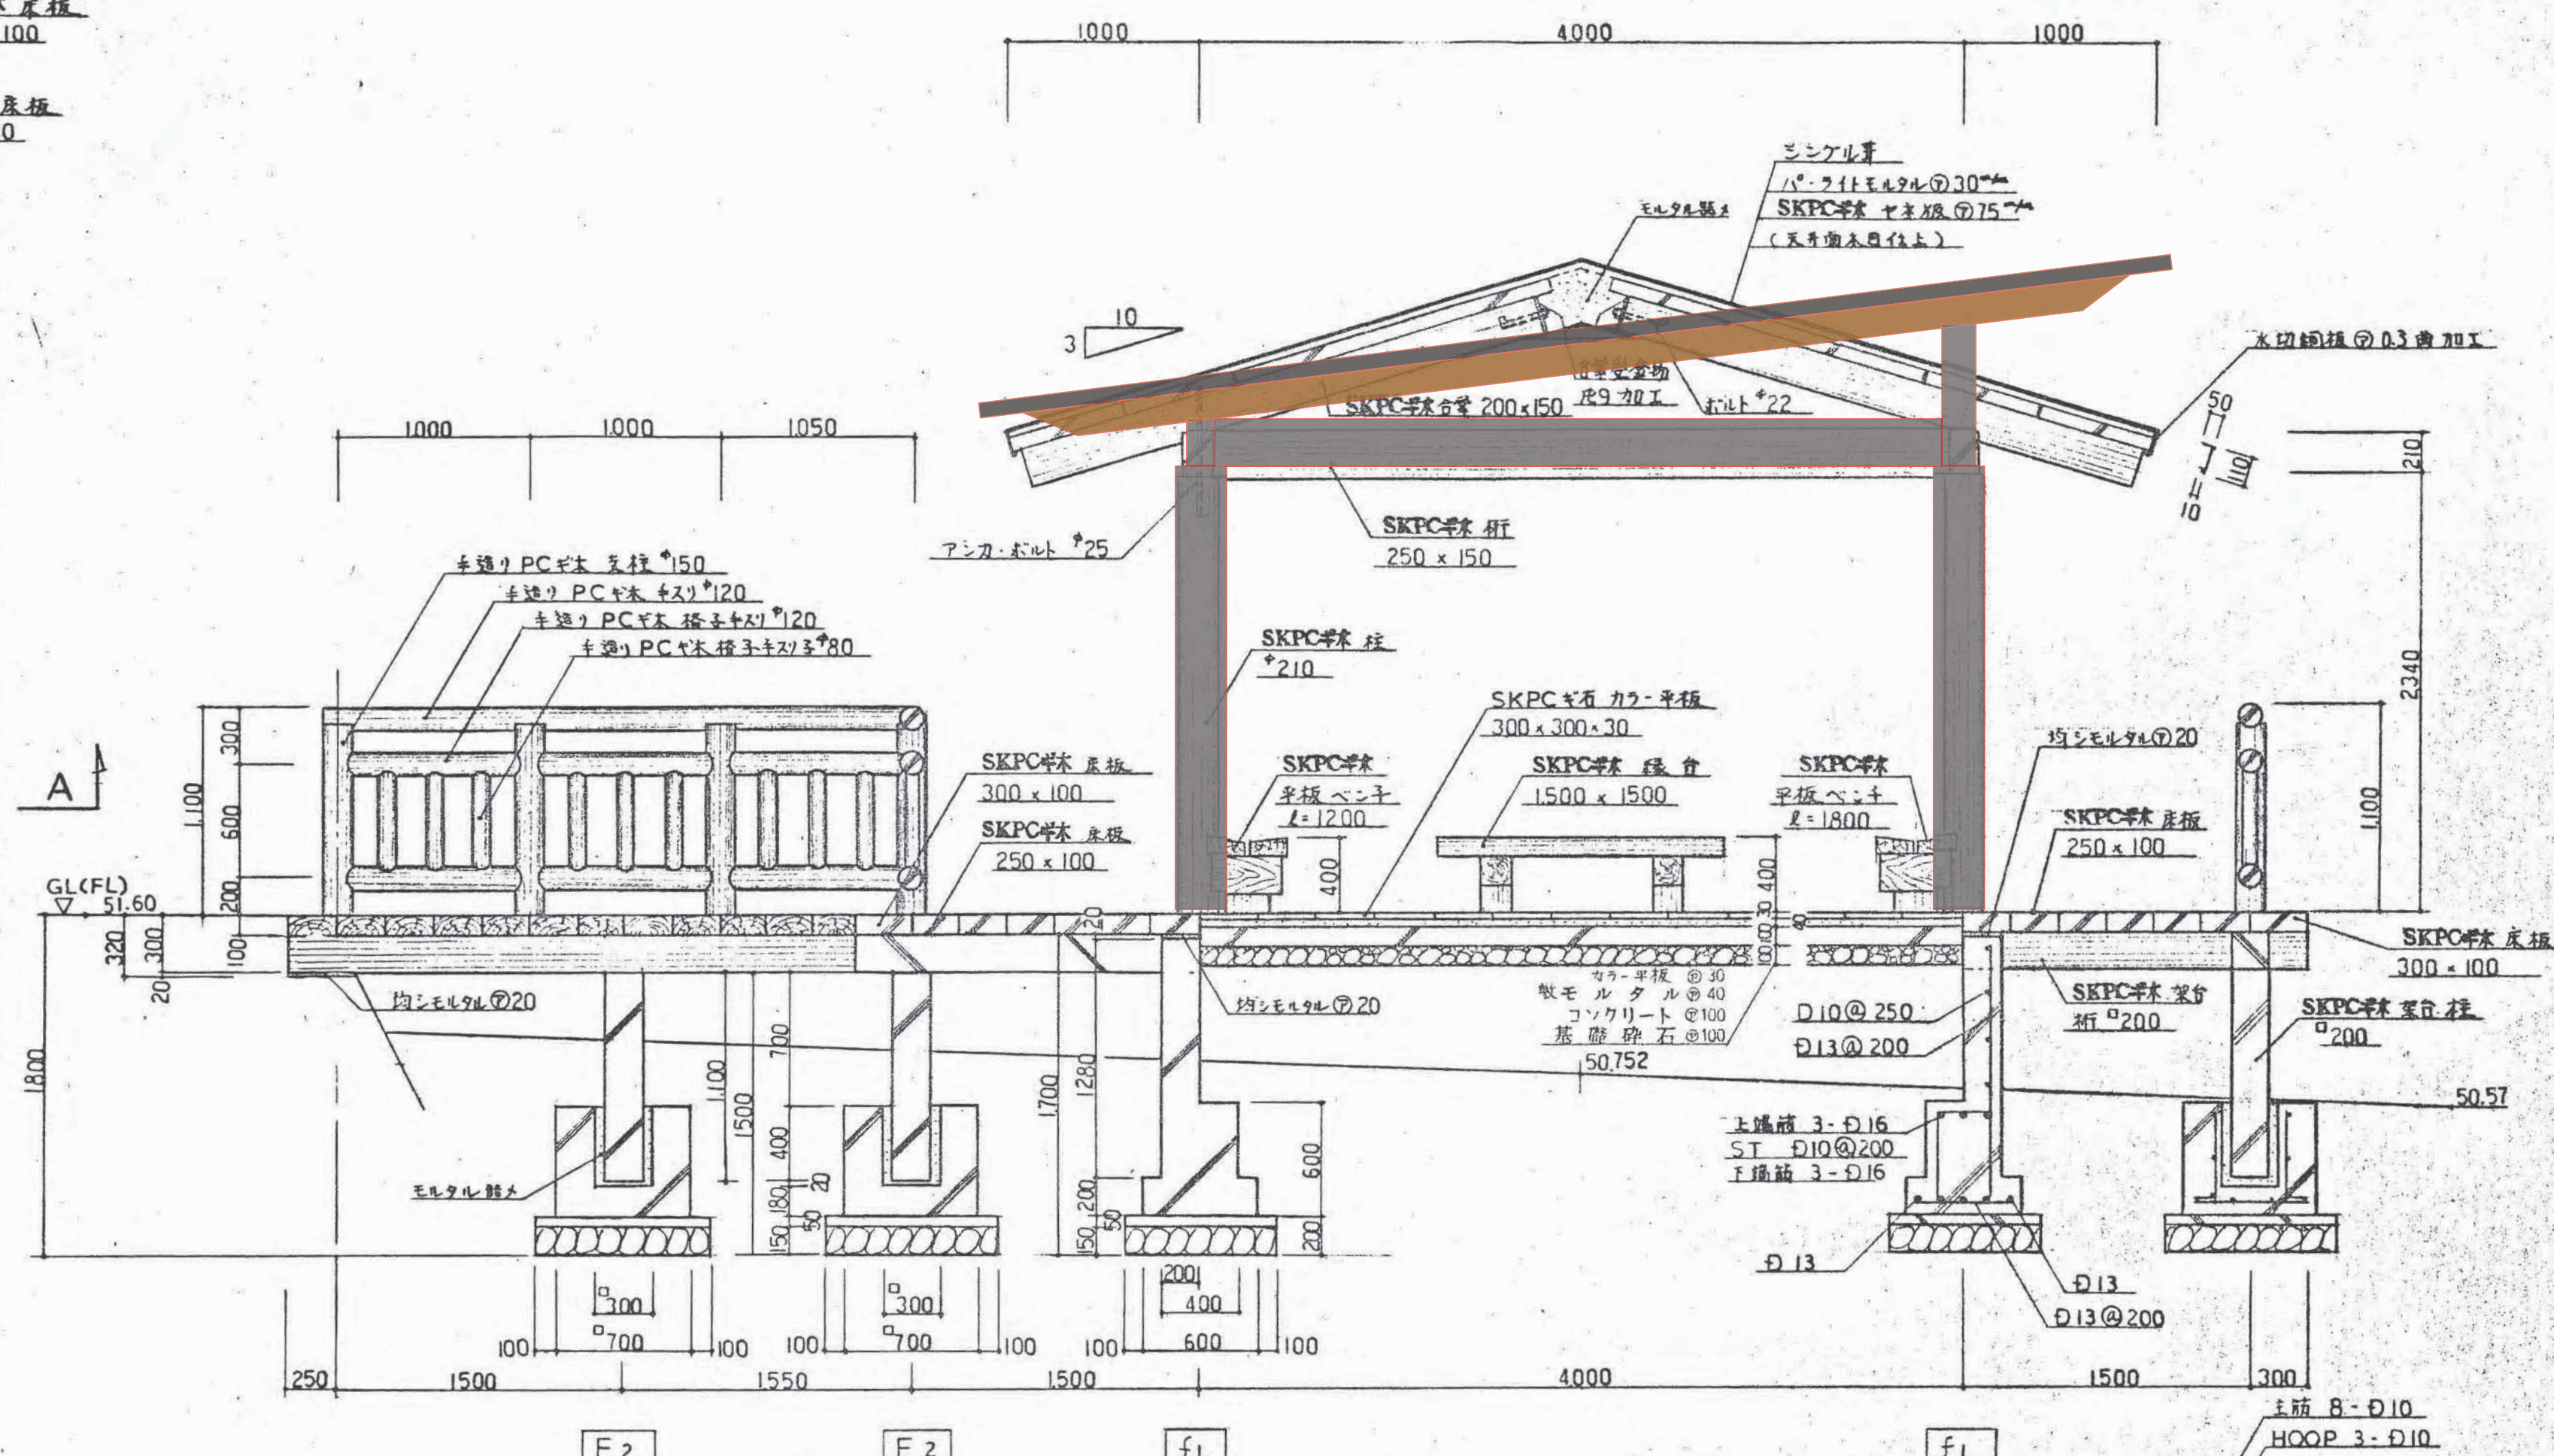


A-A 断面図 S=1:30

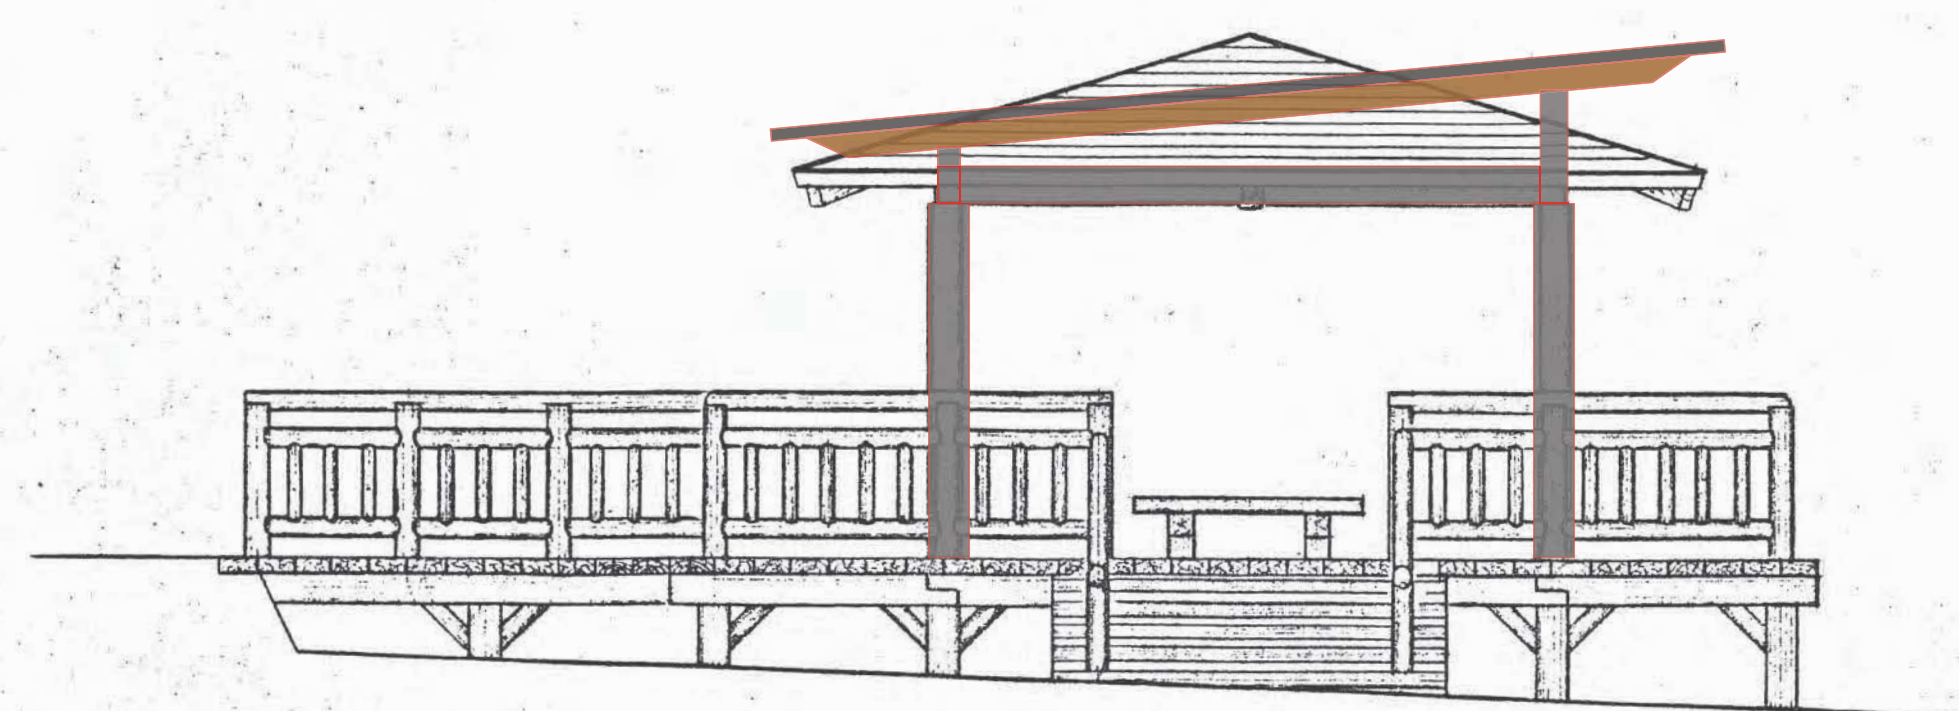

立面図 S=1:50

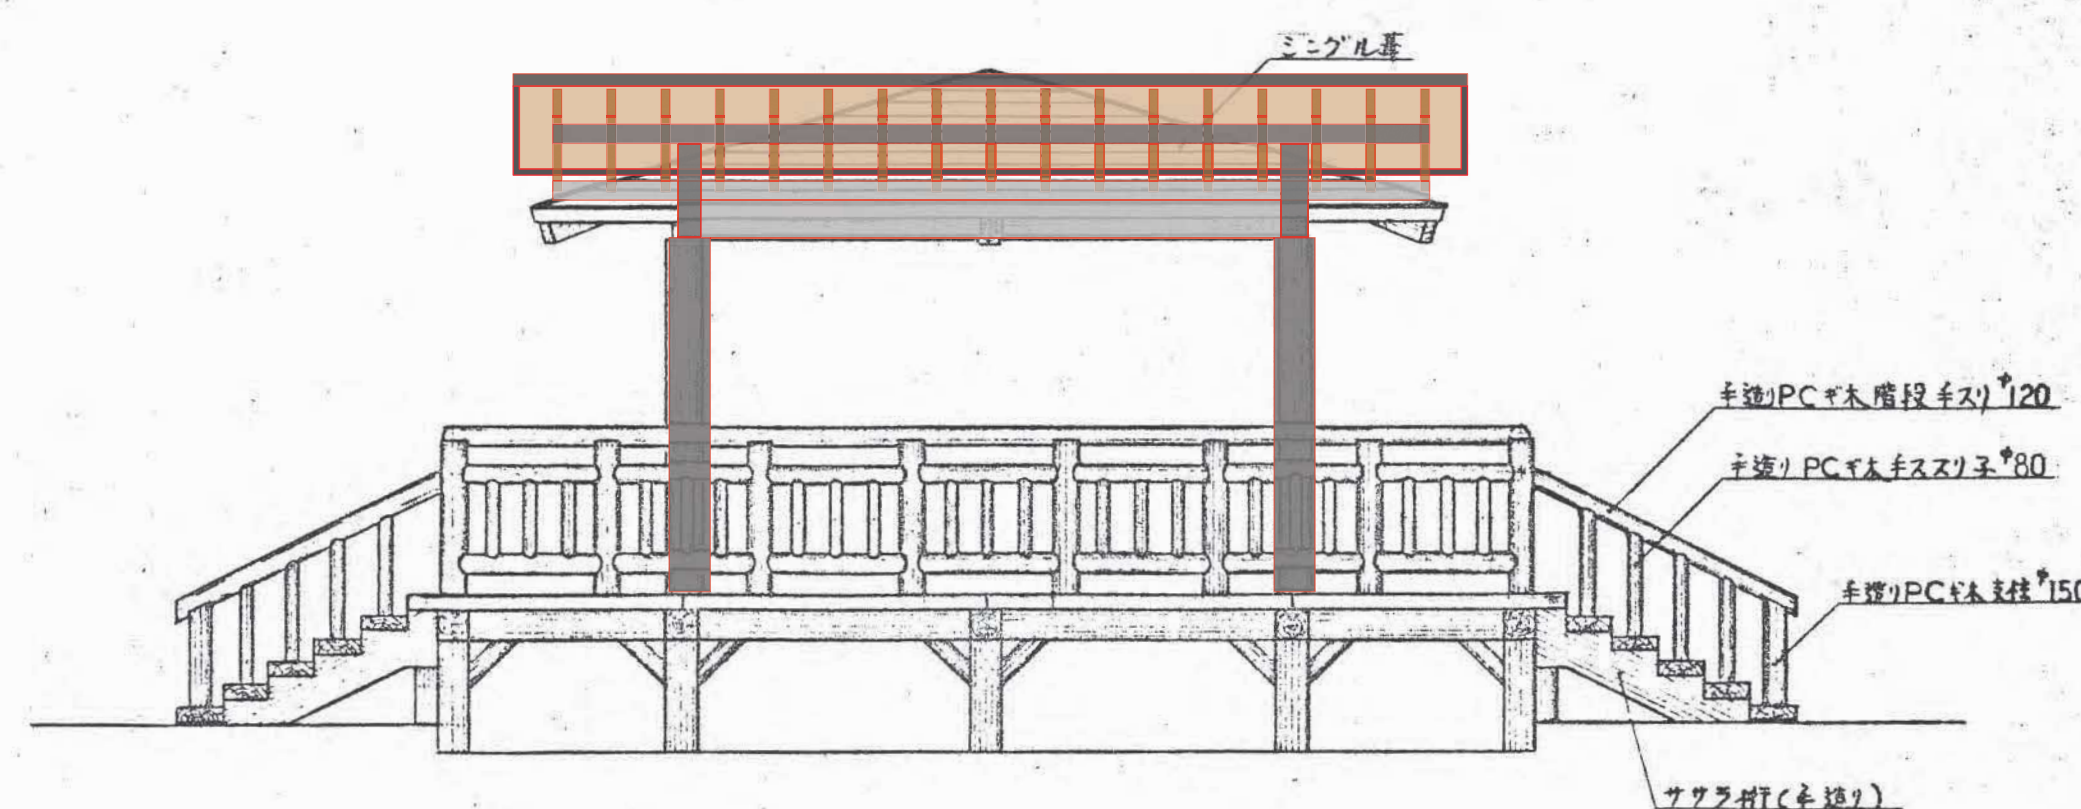

立面図 S=1:50

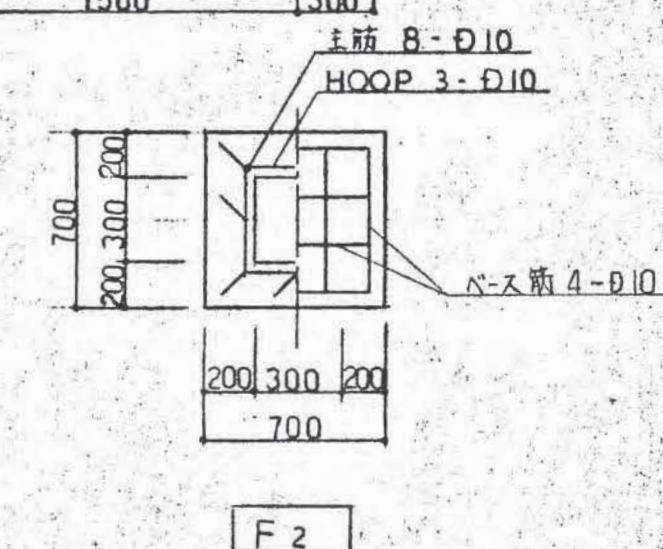

F2

