




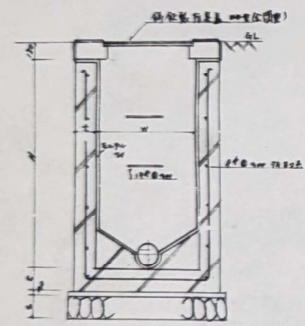



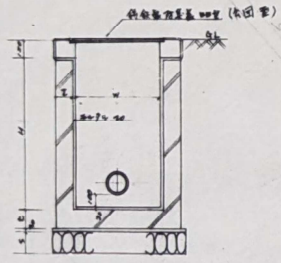



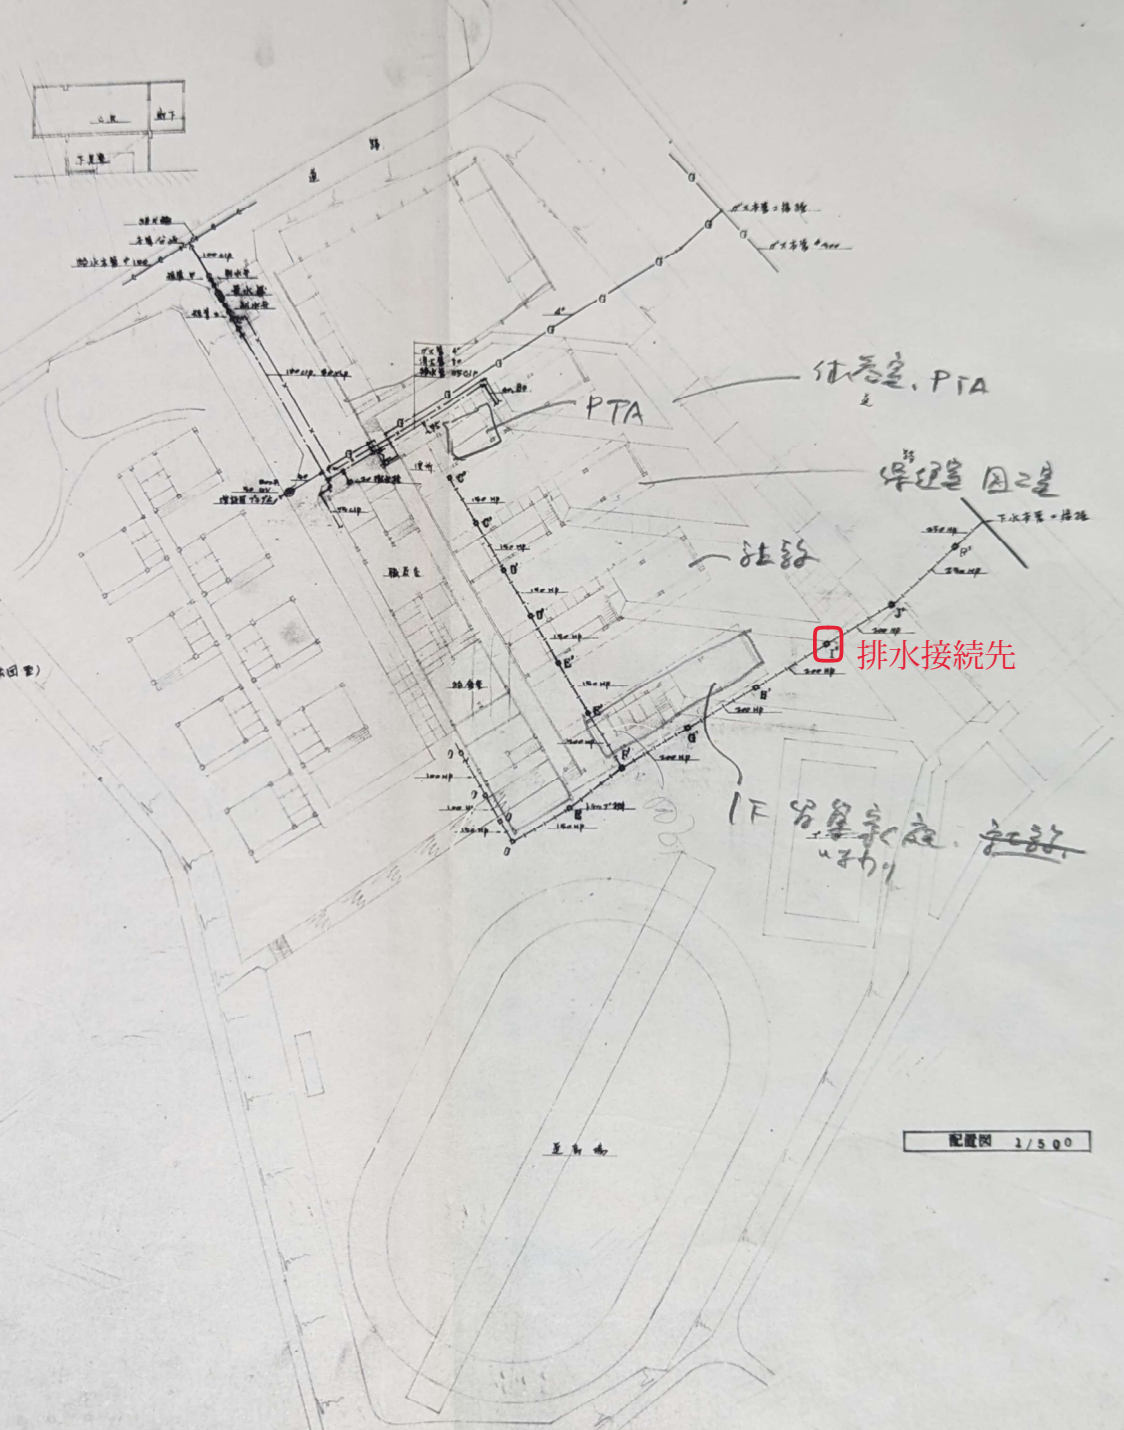



排水接続先


配置图 1/500